


# Situação de Mutua Distrito de Dondo, Mozambique 02.06.2019

Informação:

- IOM
- CCCM
- Benedito Boni Mucuaranha SDPI Dondo
- Orthophoto of 01.06.2019 and 31.05.2019
- Google Earth

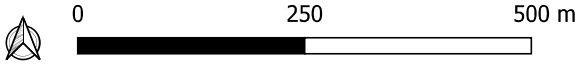

Disclaimer: This map is for illustration purposes only. Names and boundaries on this map do not imply official endorsement or acceptance by IOM

**AS BUILT**

**Informação**

- Area: 93.7ha / 937.000m<sup>2</sup>
- 289 HH (as per 01.06.2019)
- Planned plots: 836 plots
- 566 plots demarcated (as per 01.06.2019)
- 292 plots cleaned and ready (as per 01.06.2019)
- Totale rua 12m existente: 628m
- Totale rua 10m existente: 2332m
- Totale rua 12m plano: 5140m
- Totale rua 10m plano: 7279m
- IOM responsible for clearance: Iassin Carlos FAQUIRA, tel: 842122063
- SDPI responsible: Benedito Boni Mucuaranha, tel: 849291036
- WASH: Oxfam/COSACA including sanitation
- FIPAG with water connection and water trucking
- 43 latrine blocks (as per 29.05.2019)
- Protection: Action Social
- Education: Unicef
- Child friendly space: Save the Children

**LEGENDA**

- Latrines existente
- Rua existente
- Rua plano
- Tanque agua
- Mercado
- Posto policial
- Orfanato
- Educação
- Posto de Saude
- ▭ Area Mutua
- Zonas baixas
- influxo 50 familias
- 5 blocos
- 5 latrinas comunitarias

